



MAP#20, LOT 276
 AREA=1.5 ACRES

FALL RIVER AVENUE

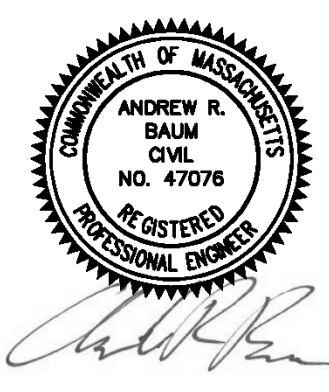

15 FALL RIVER AVE.
 "FINAL AS-BUILT"
 PLAN OF LAND
 IN
SEEKONK, MA
 12-16-20 ADDED FIELD WORK.
 DATE: JULY 14, 2020
 SCALE: 1"=20'

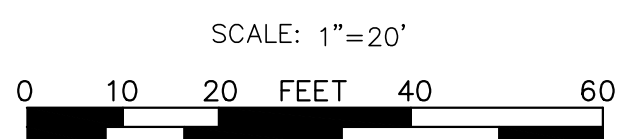

OWNER/APPLICANT: KEVIN WILLIAMS
 15 FALL RIVER AVENUE
 SEEKONK, MA 02771
Landmark Site Design
 CIVIL ENGINEERING & LAND SURVEYING
 1267 GLEBE STREET, TAUNTON MA 02780
 (774)-265-0851